

© – TE Connectivity. All Rights Reserved.

REVISIONS					
P	LTR	DESCRIPTION	DATE	DWN	APVD
	H4	REVISED PER ECR-25-251256	17FEB2026	LP	MFP

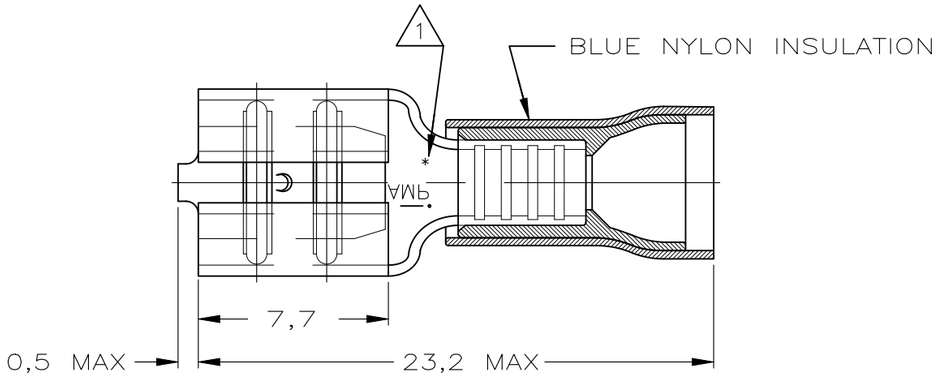

NOTES

1. ASTERISK * FOR PH.BRONZE VERSIONS ONLY.
2. WIRE RANGE: 1,0–2,6mm². INSUL. RANGE: 4,3mm MAX. DIA..
3. OBSOLETE WITHOUT REPLACEMENT

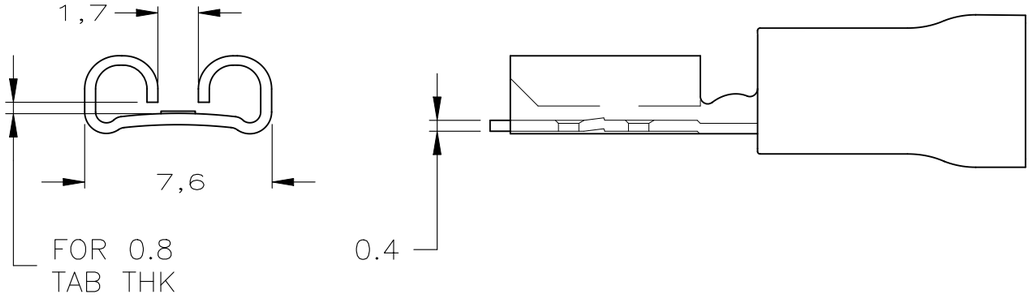

PACKAGE TYPE		FINISH	MATERIAL	PARTNUMBER
TAPE MOUNTED	1	GOLDPLATED	PH.BRONZE	~~5-160313-7~~ 3
	1	SILVERPLATED	PH.BRONZE	~~5-160313-6~~ 3
	1	TINPLATED	PH.BRONZE	~~5-160313-5~~ 3
		GOLDPLATED	BRASS	~~5-160313-4~~ 3
		SILVERPLATED	BRASS	~~5-160313-3~~ 3
		TINPLATED	BRASS	~~5-160313-2~~ 3
LOOSE PIECE	1	TIN-LEAD	PH.BRONZE	~~9-160313-8~~ 3
	1	GOLDPLATED	PH.BRONZE	~~9-160313-7~~ 3
	1	SILVERPLATED	PH.BRONZE	9-160313-6
	1	TINPLATED	PH.BRONZE	9-160313-5
		GOLDPLATED	BRASS	~~9-160313-4~~ 3
		SILVERPLATED	BRASS	~~9-160313-3~~ 3
		TINPLATED	BRASS	9-160313-2

THIS DRAWING IS A CONTROLLED DOCUMENT.

DIMENSIONS: mm

TOLERANCES UNLESS OTHERWISE SPECIFIED:

0 PLC	± –
1 PLC	± –
2 PLC	± 0.38
3 PLC	± –
4 PLC	± –
ANGLES	± –

MATERIAL: –

FINISH: –

DWN	JR RUTH	08OCT04
CHK	T MICHIELUTTI	08OCT04
APVD	T MICHIELUTTI	08OCT04
PRODUCT SPEC	–	
APPLICATION SPEC	–	
WEIGHT	–	

TE Connectivity

NAME: .250 SRS P.I.D.G. FASTON REC. –

SIZE	CAGE CODE	DRAWING NO	RESTRICTED TO
A3	00779	C-160313	–

CUSTOMER DRAWING | SCALE – | SHEET 1 OF 1 | REV H4

Downloaded from Arrow.com.