

THIS DRAWING IS UNPUBLISHED. RELEASED FOR PUBLICATION 2008
© COPYRIGHT 2008 ALL RIGHTS RESERVED.


LOC	DIST
1	–


REVISIONS


P	LTR	DESCRIPTION	DATE	DWN	APVD
	E2	ECN-24-281324	26AUG2024	TL	FL
	E3	REVISED PER ECN-26-383475	15MAY2026	CM	DK
	E4	REVISED PER ECR-26-280469	25MAY2026	CM	FL
	E5	REVISED PER ECR-26-281922	10JUN2026	CM	FL

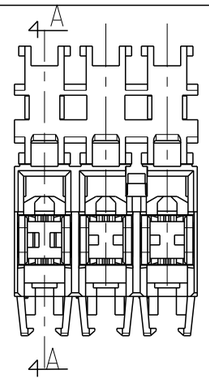

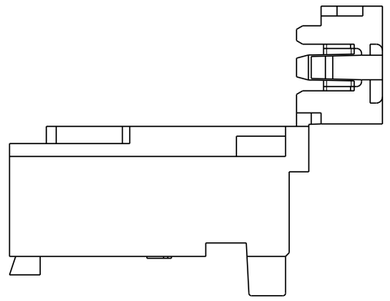

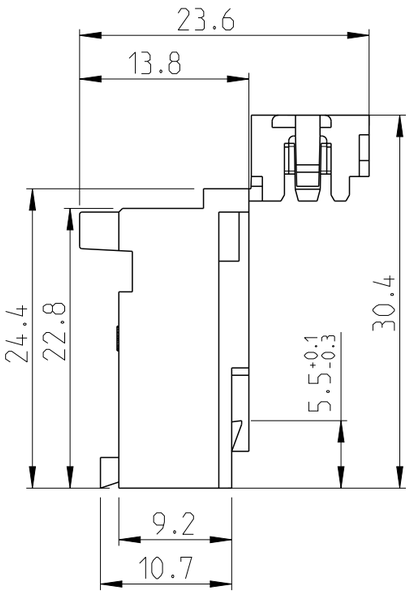


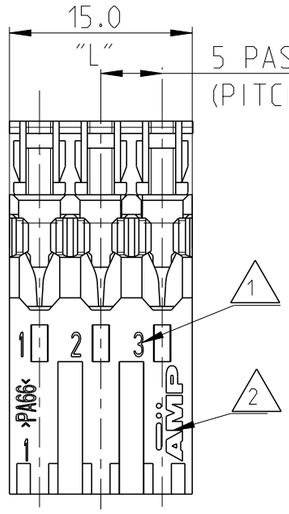

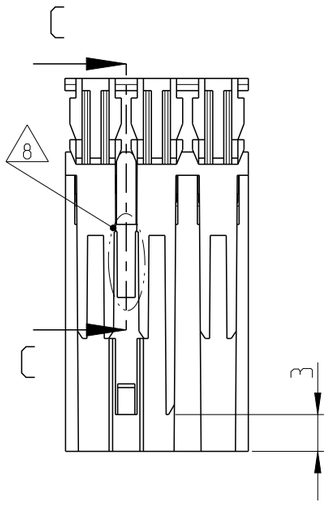


SEZ. A-A


COLOR CODE STRIP ALLOCATO
IN QUESTA AREA DEL COPERCHIO
(COLOR CODE STRIP
LOCATED ON THE COVER AS SHOWN)

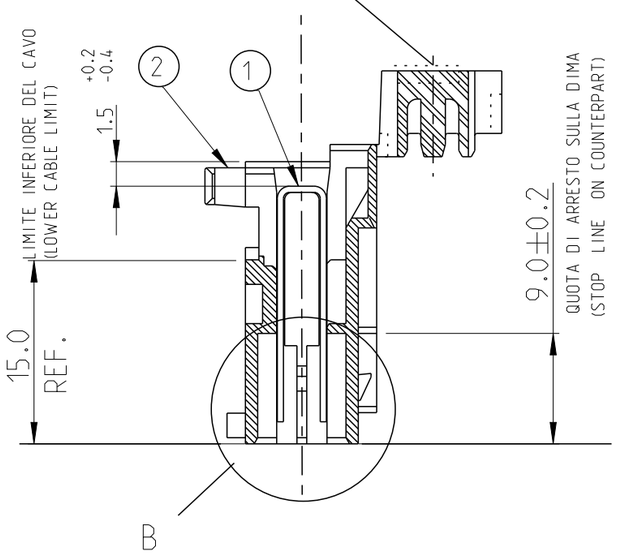

DETTAGLIO "B" CAVITA' 1
DENTINI DI RITENZIONE PER
CONTROPARTE TAB


(DETAIL "B" FOR CAVITY 1
TAB RETENTION TEETH GEOMETRY)

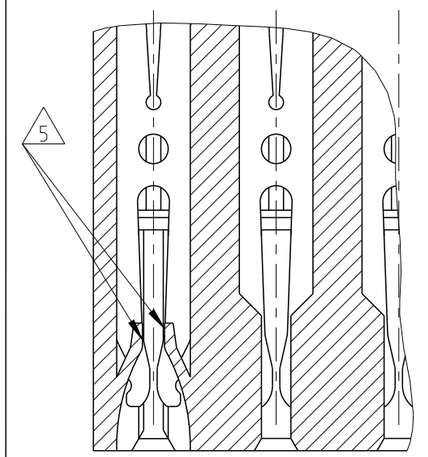

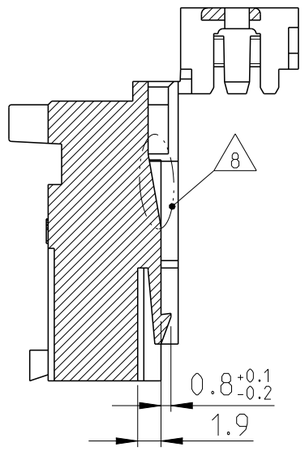

SECTION C-C
2:1

DETTAGLIO "B" CAVITA' 2 ,3 E 4
(DETAIL "B" FOR CAVITY 2,3 & 4)

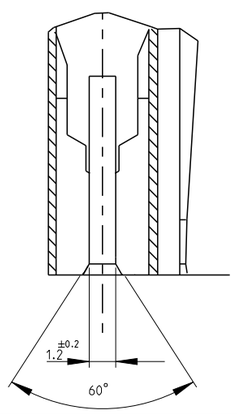

ITEM	DENOMINAZIONE (DESCRIPTION)	FINITURA / COLORE (FINISH / COLOUR)	MATERIALE (MATERIAL)	DIAM. ISOLANTE (INS. DIA. RANGE)	RANGO FILO (WIRE RANGE)
2	BLOCCHETTO (HOUSING)	NATURALE (NATURAL)	PA 6.6 CARICATO VETRO (POLIAMIDE 6.6 GLASSFIBER FILLED)	3,0 max.	0.5-1.5mm2
1	CONTATTO (CONTACT)	STAGNATO (TIN-PLATED)	OTTONE (BRASS)		

THIS DRAWING IS A CONTROLLED DOCUMENT.

DIMENSIONS: mm

TOLERANCES UNLESS OTHERWISE SPECIFIED:
0 PLC ±
1 PLC ±
2 PLC ± ±0.3
3 PLC ±
4 PLC ±
ANGLES ±0° 30'

MATERIAL SEE TABLE

FINISH SEE TABLE

DWN C.CORDOLA 02DEC2008
CHK G.TURCO 02DEC2008
APVD – –
PRODUCT SPEC 108-20065-1 108-20065-2
APPLICATION SPEC 114-20016 – 114-20016-1
WEIGHT –

TE Connectivity

NAME
MONO SHAPE MK I TAB
SPECIAL 2-8 POS REAR LOCKING
–

SIZE	CAGE CODE	DRAWING NO	RESTRICTED TO
A3	00779	C-293491	–

CUSTOMER DRAWING

SCALE	SHEET	REV
2:1	1 OF 3	E5

1470-19 (3/11)

Downloaded from Arrow.com.

THIS DRAWING IS UNPUBLISHED. RELEASED FOR PUBLICATION 2008
© COPYRIGHT 2008 ALL RIGHTS RESERVED.


LOC	DIST
1	–

REVISIONS

P	LTR	DESCRIPTION	DATE	DWN	APVD
		~~SEE SHEET 1~~ SEE SHEET 1			

NUMERO DI VIE NO OF POS	CONFIGURAZIONE (Vista connettore dall'alto) (1) CONFIGURATION (View from top side) (1)	VERSIONE PEZZI IN VASSOIO TRAY PACKAGING VERSION	PART REV.	VERSIONE PEZZI SCIOLTI LOOSE PIECES PACKAGING VERSION	PART REV	POSIZIONE AGGANCIO (LATO POSTERIORE) LOCKING POSITION (Back side)	POSIZIONE POLARIZZAZIONE (LATO POSTERIORE) (SE PRESENTE) POSITION FOR POLARIZATION ON BACK SIDE (IF PRESENT)	L +0.2 -0.3 (mm)	NOTE MARCHIATURA CON BANDA COLORATA NOTE STRIP COLOUR
2	△4	0-293491-2	D	-	-	1-2	1S-2D	9.9	-
	△4	1-293491-2	D	-	-	1-2	1S	9.9	-
	△4	2-293491-2	D	-	-	1-2	-	9.9	-
3	△4	0-293491-3	D	-	-	2-3	2S	14.9	-
3	△4	1-293491-3	D	-	-	1-2	1S-2D	14.9	BLACK
4	△4	0-293491-4	D	-	-	1-2, 3-4	1S,2D,3S	19.9	-
4	△4	1-293491-4	D	-	-	1-2, 3-4	1S,2D	19.9	-
8	△4	~~0-293491-8~~ △10	D	-	-	1-2, 7-8	2D,3S,6D,7S	39.9	-


SCALE 2:1
VISTA LATO ALTO
(TOP SIDE VIEW)

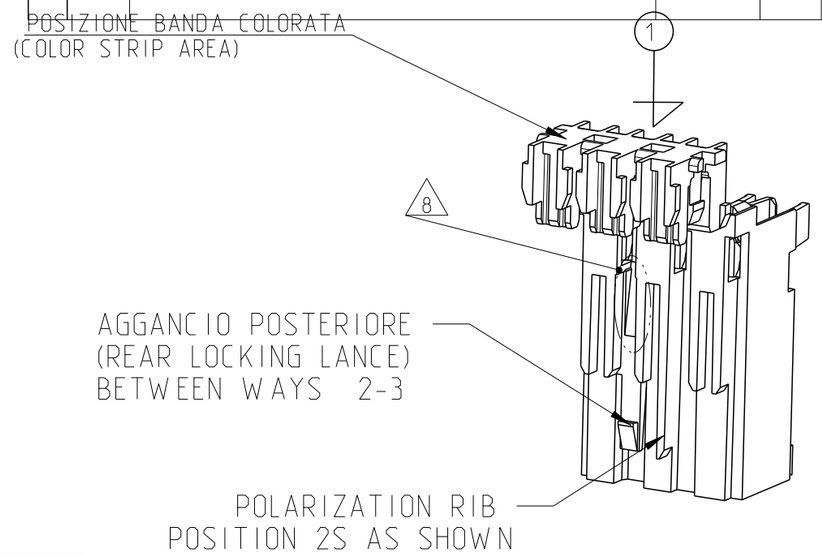


NOTE/NOTES:


1. NUMERI DI IDENTIFICAZIONE CAVITA'. (CIRCUIT IDENTIFICATION)
2. MARCHIO DI FABBRICA (LIBERA POSIZIONE). (TRADE MARK LOGO FREE POSITION)
3. L'AGGANCIO DELLA LINGUETTA E' POSIZIONATO SOLO NELLA CAVITA' N.1 (VEDI ANCHE NOTA 5) ED E' PRESENTE SOLO PER I CONNETTORI DI 2, 3 E 4 VIE. (THE RETENTION TOOTH IS LOCATED ONLY IN CAVITY N.1 (SEE ALSO NOTE 5) AND IS PRESENT ONLY FOR CONNECTORS WITH 2, 3 AND 4 POSITIONS).
4. DIVENTA 6.5 PER LA CAVITA' N. 1 SUI CONNETTORI (BECOMES 6.5. FOR THE CAVITY N.1)
5. GEOMETRIA ALTERNATIVA E OPZIONALE DEL DENTINO DI AGGANCIO (ALTERNATIVE AND OPTIONAL SHAPE FOR RETENTION TOOTH)
6. STATO DI FORNITURA: CONFEZIONAMENTO IN "VASSOI + SCATOLA" (PACKAGING: "ON TRAY PLUS CARTON BOX")
7. PRELIMINARY- PART NOT YEST RELEASED FOR PRODUCTION
8. SLIDE PROFILE (WEDGE SHAPE SLOT) ON THE AREA ABOVE THE LOCKING LANCE GEOMERTY TO FACILITATE UN-CHAINING PROCESS.
9. DIFFERENT CODING RIB GEOMETRY AT BOTH END. WIDTH OF CODING RIB REDUCED TO 1.1 mm FOR ALL REAR LOCKING VERSIONS
10. OBSOLETE
11. WITHOUT 2 WIRE RETENTION HOOKS ON 2 ENDS. SEE SHEET 3
12. SPECIAL CIRCUITE INDENTIFICATION, WHICH IS OPPOSITE FROM STANDARD ONE. SEE SHEET 3

PEZZO FORNITO AGGANCIATO IN STICK
(CONNECTORS STACKED IN STRIP)

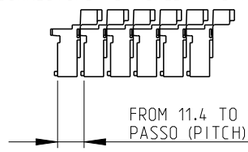

CONNETTORE CHIUSO AGGRAFFATO
(TERMINATED CONNECTOR)

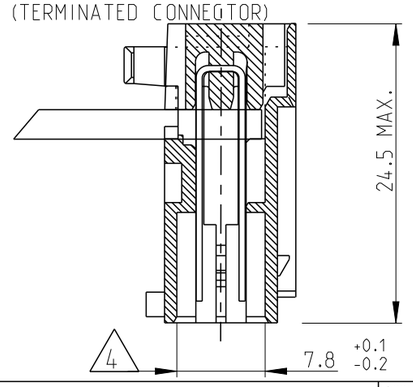

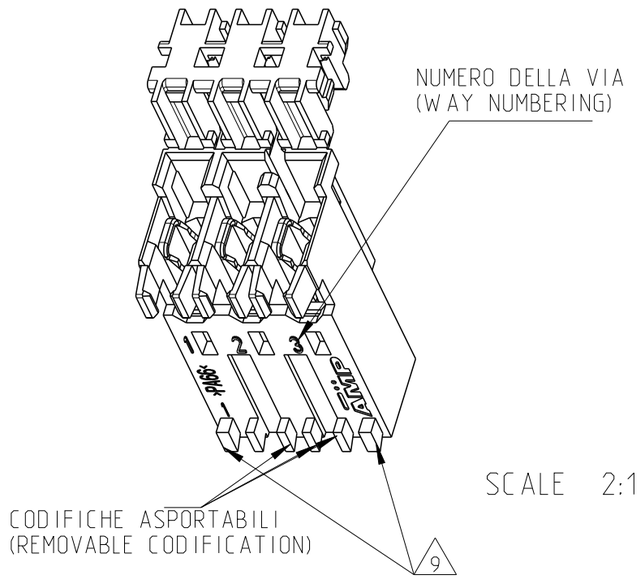

SCALE 2:1

THIS DRAWING IS A CONTROLLED DOCUMENT.

DIMENSIONS: mm

TOLERANCES UNLESS OTHERWISE SPECIFIED:
0 PLC ±
1 PLC ±
2 PLC ± } ±0.3
3 PLC ±
4 PLC ±
ANGLES ±0° 30'

MATERIAL SEE TABLE
FINISH SEE TABLE

DWN	C.CORDOLA 02DEC2008
CHK	G.TURCO 02DEC2008
APVD	– –
PRODUCT SPEC	108-20065-1 108-20065-2
APPLICATION SPEC	114-20016 – 114-20016-1
WEIGHT	–

TE Connectivity

NAME
MONO SHAPE MK I TAB
SPECIAL 2-8 POS REAR LOCKING
–

SIZE	CAGE CODE	DRAWING NO	RESTRICTED TO
A3	00779	C-293491	–

CUSTOMER DRAWING | SCALE 2:1 | SHEET 2 OF 3 | REV E5

Downloaded from Arrow.com.


THIS DRAWING IS UNPUBLISHED. RELEASED FOR PUBLICATION 2008
© COPYRIGHT 2008 ALL RIGHTS RESERVED.


LOC	DIST
1	–


REVISIONS

P	LTR	DESCRIPTION	DATE	DWN	APVD
		SEE SHEET 1			

PA GF, UL-V0 GWEPT 750°C NO FLAME, NATURAL
TWO ALTERNATIVE RESINS

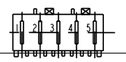	NO OF POS	CONFIGURATION (View from top side) ①	TRAY PACKAGING VERSION	PART REV	LOOSE PIECES PACKAGING VERSION	PART REV	LOCKING POSITION (Back side)	POSITION FOR POLARIZATION ON BACK SIDE (IF PRESENT)	L +0.2 -0.3 (mm)	NOTE STRIP COLOUR
	2		2297762-2	D	-	-	1-2	1S-2D	9.9	-
			1-2297762-2	1	-	-	1-2	1S	9.9	-
7	3		2297762-3	1	-	-	1-2	1S-2D	14.9	-
	3		1-2297762-3	D	-	-	1-2	1D-2S-3D	14.9	-
	3		3-229762-3	1	-	-	2-3	2S	14.9	-
7	4		2297762-4	D	-	-	1-2, 3-4	1D-2S-3D	19.9	-
7	5		2297762-5	1	-	-	2-3, 4-5	2S-4S	24.9	-
	8		2297762-8	1	-	-	TBD	TBD	39.9	-

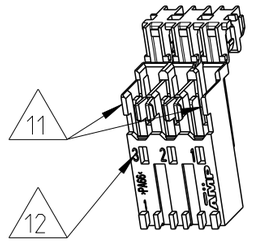

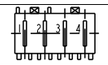NUMERO DI VIE	① CONFIGURAZIONE (Vista connettore dall'alto)	VERSIONE PEZZI IN VASSOIO	PART REV.	VERSIONE PEZZI SCIOLTI	PART REV	POSIZIONE AGGANCIO (LATO POSTERIORE)	POSIZIONE POLARIZZAZIONE (LATO POSTERIORE) (SE PRESENTE)	L +0.2 -0.3 (mm)	NOTE MARCHIATURA CON BANDA COLORATA
NO OF POS	① CONFIGURATION (View from top side)	TRAY PACKAGING VERSION		LOOSE PIECES PACKAGING VERSION		LOCKING POSITION (Back side)	POSITION FOR POLARIZATION ON BACK SIDE (IF PRESENT)		NOTE STRIP COLOUR
4	4 	1-2469935-4	1	-	-	1-2, 3-4	1S,2D	19.9	-

THIS DRAWING IS A CONTROLLED DOCUMENT.

DIMENSIONS: mm

TOLERANCES UNLESS OTHERWISE SPECIFIED:
0 PLC ±
1 PLC ±
2 PLC ±
3 PLC ±
4 PLC ±
ANGLES ±0° 30'

MATERIAL SEE TABLE

FINISH SEE TABLE

DWN C.CORDOLA 02DEC2008
CHK G.TURCO 02DEC2008
APVD –
PRODUCT SPEC
APPLICATION SPEC –
WEIGHT –

TE Connectivity

NAME
MONO SHAPE MK I TAB
SPECIAL 2-8 POS REAR LOCKING
–

SIZE	CAGE CODE	DRAWING NO	RESTRICTED TO
A3	00779	C-293491	–

CUSTOMER DRAWING | SCALE 2:1 | SHEET 3 OF 3 | REV E5

Downloaded from Arrow.com.