
© 2025 TE Connectivity. All Rights Reserved.

REVISIONS					
P	LTR	DESCRIPTION	DATE	DWN	APVD
	A	INITIAL	07APR2015	DW	CW
	A1	ECR-25-250049	14NOV2025	RK	SC

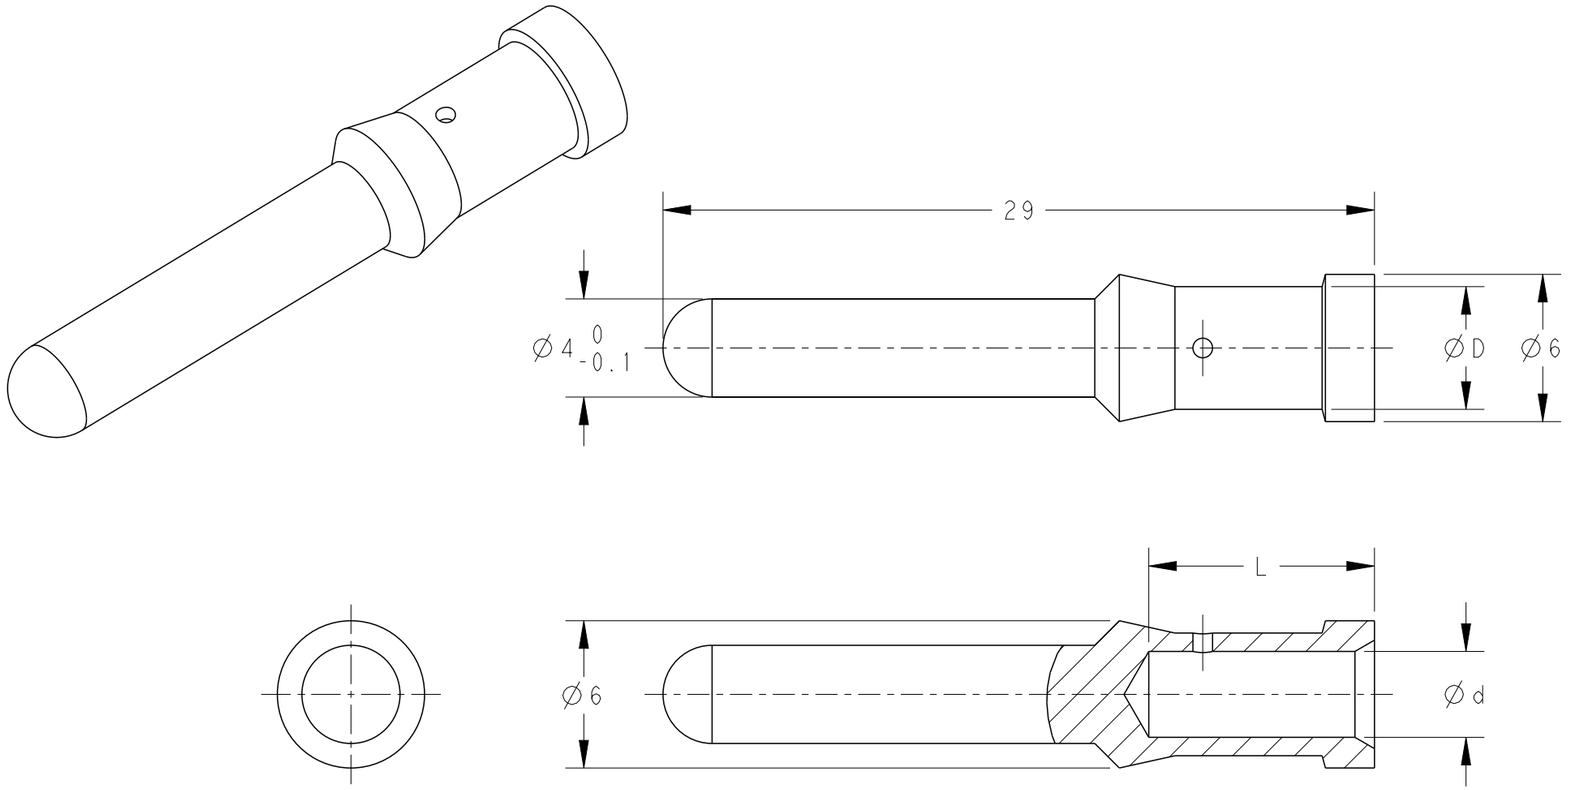

SECTION A-A

NOTES:
1. TECHNICAL CHARACTERISTICS:
   CONTACT MATERIAL: BRASS
   SURFACE PLATING:
   SILVER PLATING: >=2μm
   GOLD PLATING: >=0.75μm
   CONTACT RESISTANCE: <=3mΩ
   WIRE RANGE: 1.0-10.0 mm² (18-8 AWG)
   OPERATION TEMPERATURE: -40~+125°C

注释：
1. 技术参数：
   公针材料： 黄铜
   表面电镀：
   镀银： >=2μm
   镀金： >=0.75μm
   接触电阻： <=3mΩ
   接线范围： 1.0-10.0 mm² (18-8 AWG)
   工作温度： -40~+125°C

	PART NUMBER		Ød	ØD	WIRE GAUGE		STRIPPING LENGTH L (mm)
	SILVER PLATING	GOLD PLATING			MM²	AWG	
OBSOLETE	T2040001010-000	~~T2040011010-000~~	1.45	2.65	~~1.0~~	~~18~~	
PIN CONTACT	T2040001015-000	T2040011015-000	1.75	3.00	1.5	16	9.2
	T2040001025-000	T2040011025-000	2.25	3.45	2.5	14	
	T2040001040-000	T2040011040-000	2.85	3.85	4.0	12	
	T2040001060-000	T2040011060-000	3.50	5.00	6.0	10	
	T2040001100-000	T2040011100-000	4.30	5.60	10.0	8	

THIS DRAWING IS A CONTROLLED DOCUMENT.

DIMENSIONS: mm

TOLERANCES UNLESS OTHERWISE SPECIFIED:
0 PLC ±-
1 PLC ±-
2 PLC ±-
3 PLC ±-
4 PLC ±-
ANGLES ±-

MATERIAL -
-

FINISH -
-

DWN David Wang 25JAN2015
CHK Chris Wang 25JAN2015
APVD Xiang Xu 25JAN2015
PRODUCT SPEC 108-137053
APPLICATION SPEC 114-137053
WEIGHT -

TE Connectivity

NAME
CMM/DMM
MM PIN CONTACT

SIZE	CAGE CODE	DRAWING NO	RESTRICTED TO
A3	00779	C-T20400X10XX000	-

CUSTOMER DRAWING

SCALE 4:1 SHEET 1 OF 1 REV A1

1470-19 (3/13)

Downloaded from Arrow.com.